


MIMMS ENTERPRISES
 780 OLD ROSWELL
 PLACE SUITE 100
 ROSWELL, GA 30076
 770-518-2200

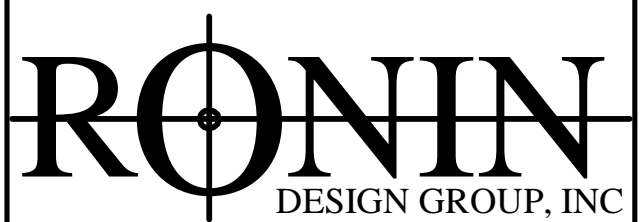

3535 PEACHTREE RD
 SUITE 520-165
 ATLANTA, GA 30326

404-705-8450 PHONE
 404-705-8449 FAX

PLAN:

**COMMERCIAL
 OFFICE/WHSE**

SUITE 204
 2065 PTREE
 INDUST. CT
 CHAMBLEE, GA
 30341

DETAIL:

AS-BUILT
 LAYOUT

DATE DRAWN:

OCTOBER 24, 2008

SCALE:


AS SHOWN

JOB NO:

SHEET:

A-1

1 OF SHEETS 1

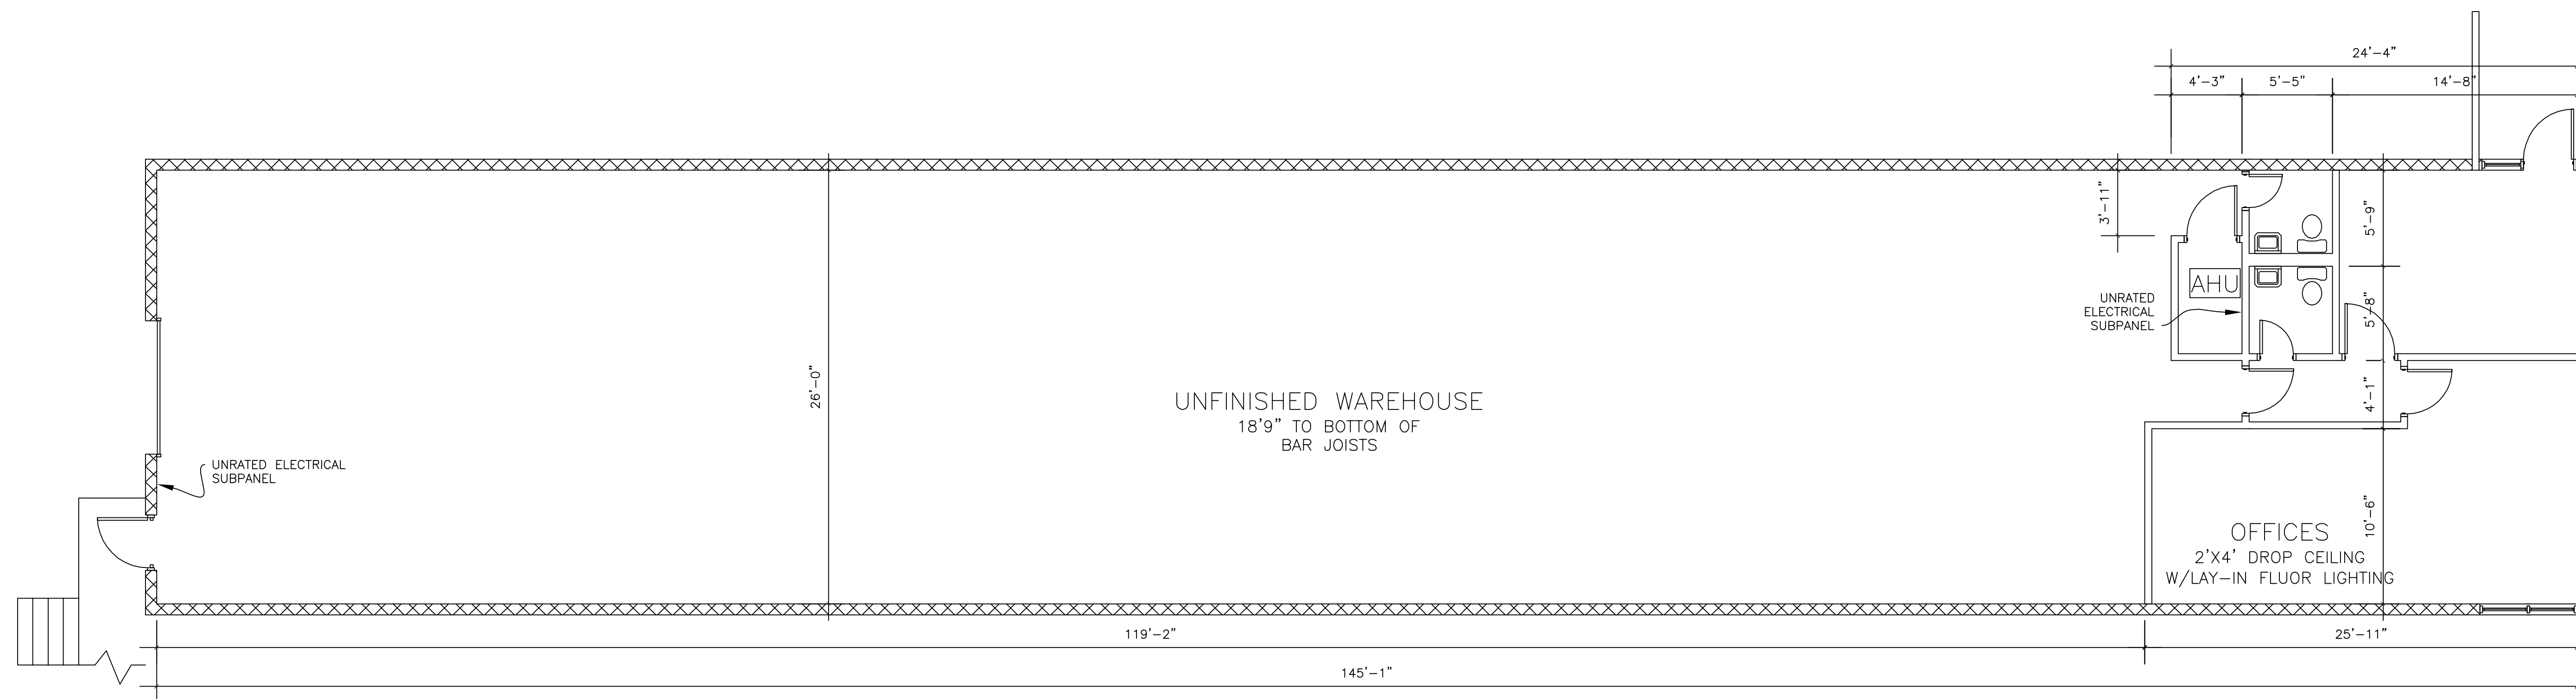

EXISTING FLOOR PLAN:
 SCALE: 3/16" = 1'

NOTE: DIMENSIONS ARE FOR INTERIOR REFERENCE ONLY,
 AND DO NOT REFLECT TOTAL SUITE SQUARE FOOTAGE.