

MIMMS ENTERPRISES
 780 OLD ROSWELL
 PLACE SUITE 100
 ROSWELL, GA 30076
 770-518-2200



6075 ROSWELL RD, NE
 SUITE 118
 ATLANTA, GA 30328

404-705-8450 PHONE
 404-705-8449 FAX

PLAN:

2065 PTREE IND CT
 SUITE 206
 CHAMBLEE, GA
 30341

DETAIL:

AS-BUILT
 LAYOUT

DATE DRAWN:

DECEMBER 13, 2007

SCALE:


AS SHOWN

JOB NO:

SHEET:

A-1

1 OF SHEETS 1

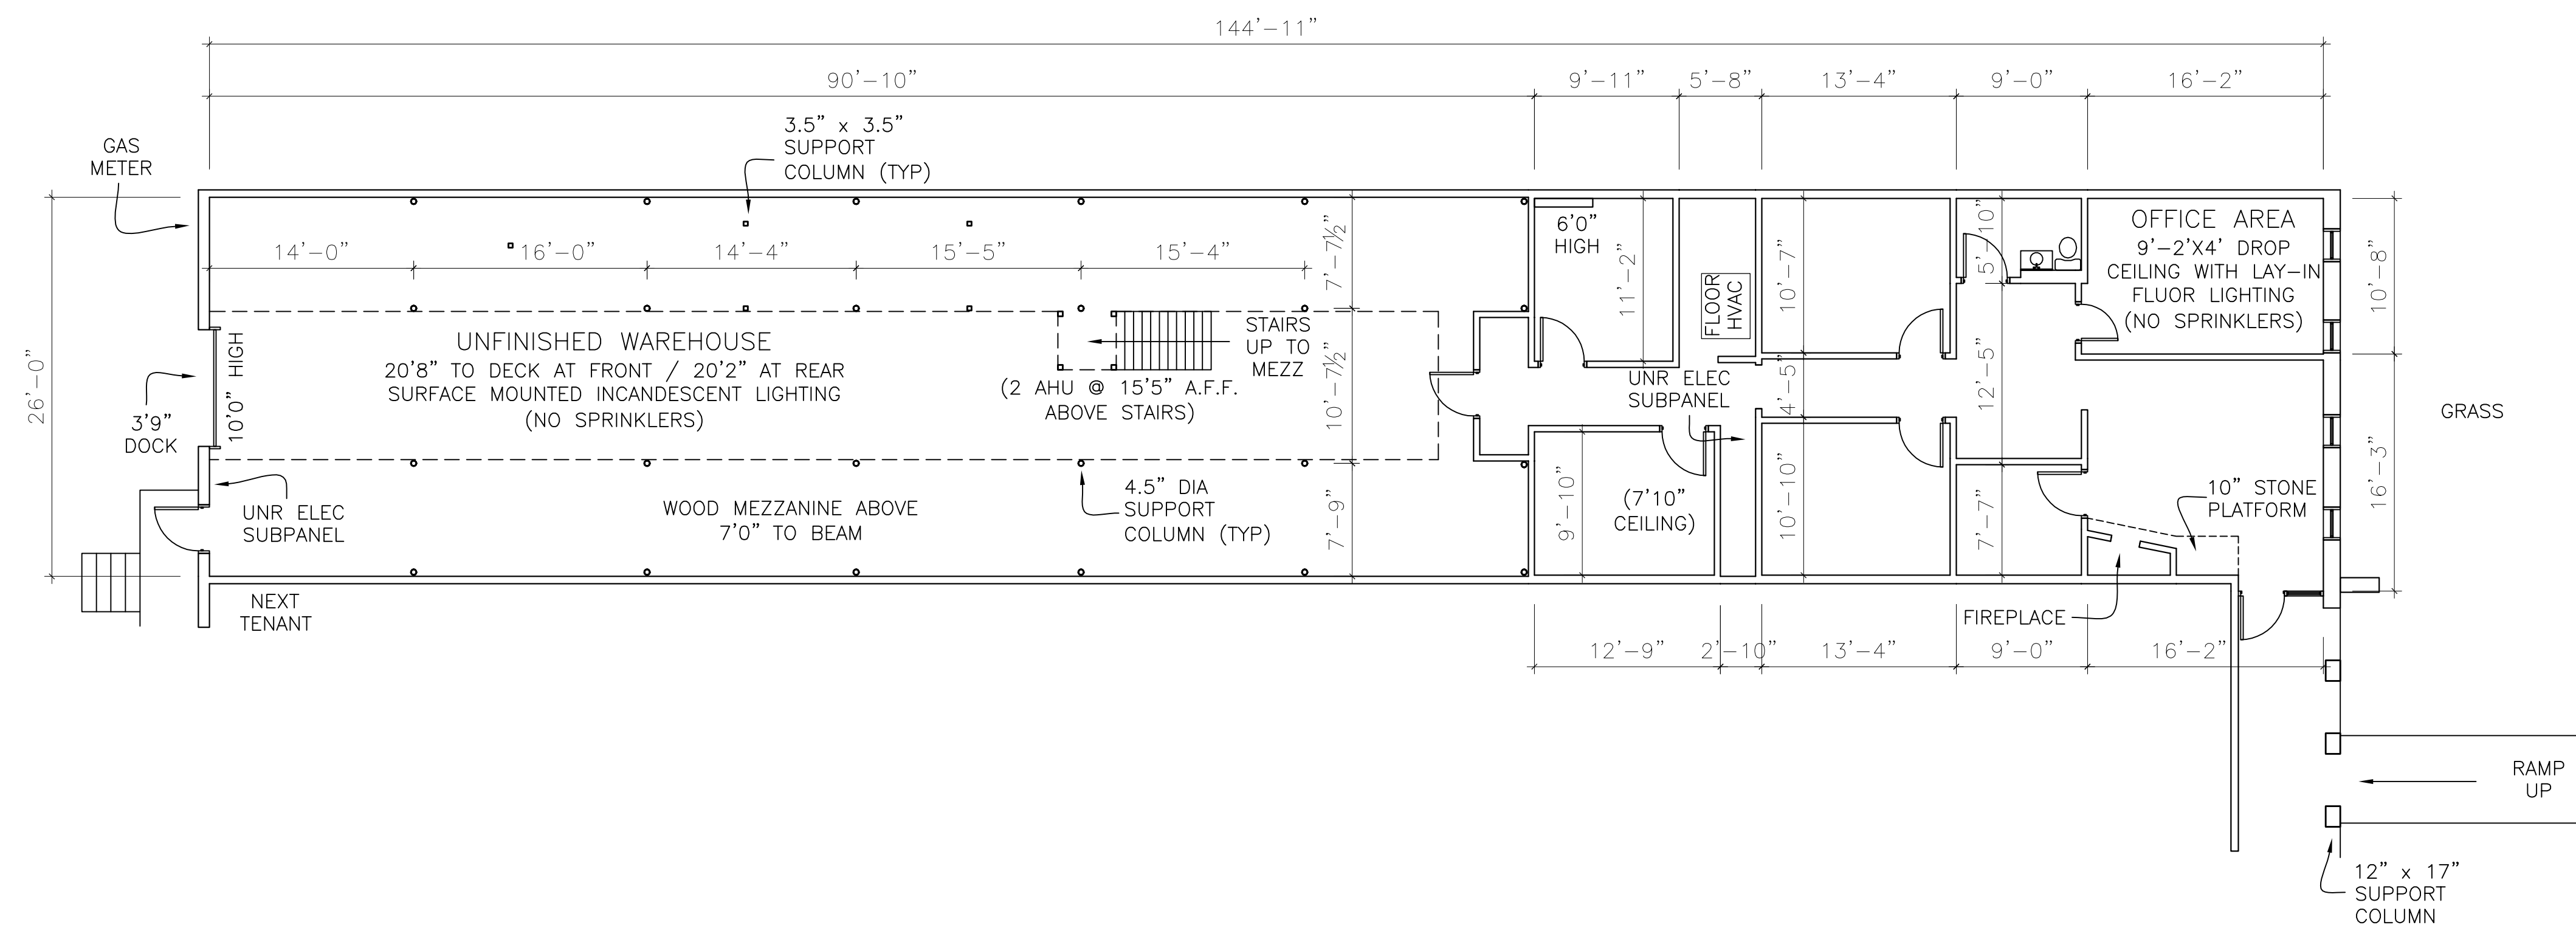

EXISTING FLOOR PLAN:
 SCALE: 1/8" = 1'-0"

NOTE: DIMENSIONS ARE FOR INTERIOR REFERENCE ONLY,
 AND DO NOT REFLECT TOTAL SUITE SQUARE FOOTAGE.