

MIMMS ENTERPRISES  
 780 OLD ROSWELL  
 PLACE SUITE 100  
 ROSWELL, GA 30076  
 770-518-2200



6075 ROSWELL RD, NE  
 SUITE 118  
 ATLANTA, GA 30328

404-705-8450 PHONE  
 404-705-8449 FAX

PLAN:

2065 PTREE IND CT  
 SUITE 206  
 CHAMBLEE, GA  
 30341

DETAIL:

AS-BUILT  
 LAYOUT

DATE DRAWN:

DECEMBER 13, 2007

SCALE:


AS SHOWN

JOB NO:

SHEET:

A-1

1 OF SHEETS 1

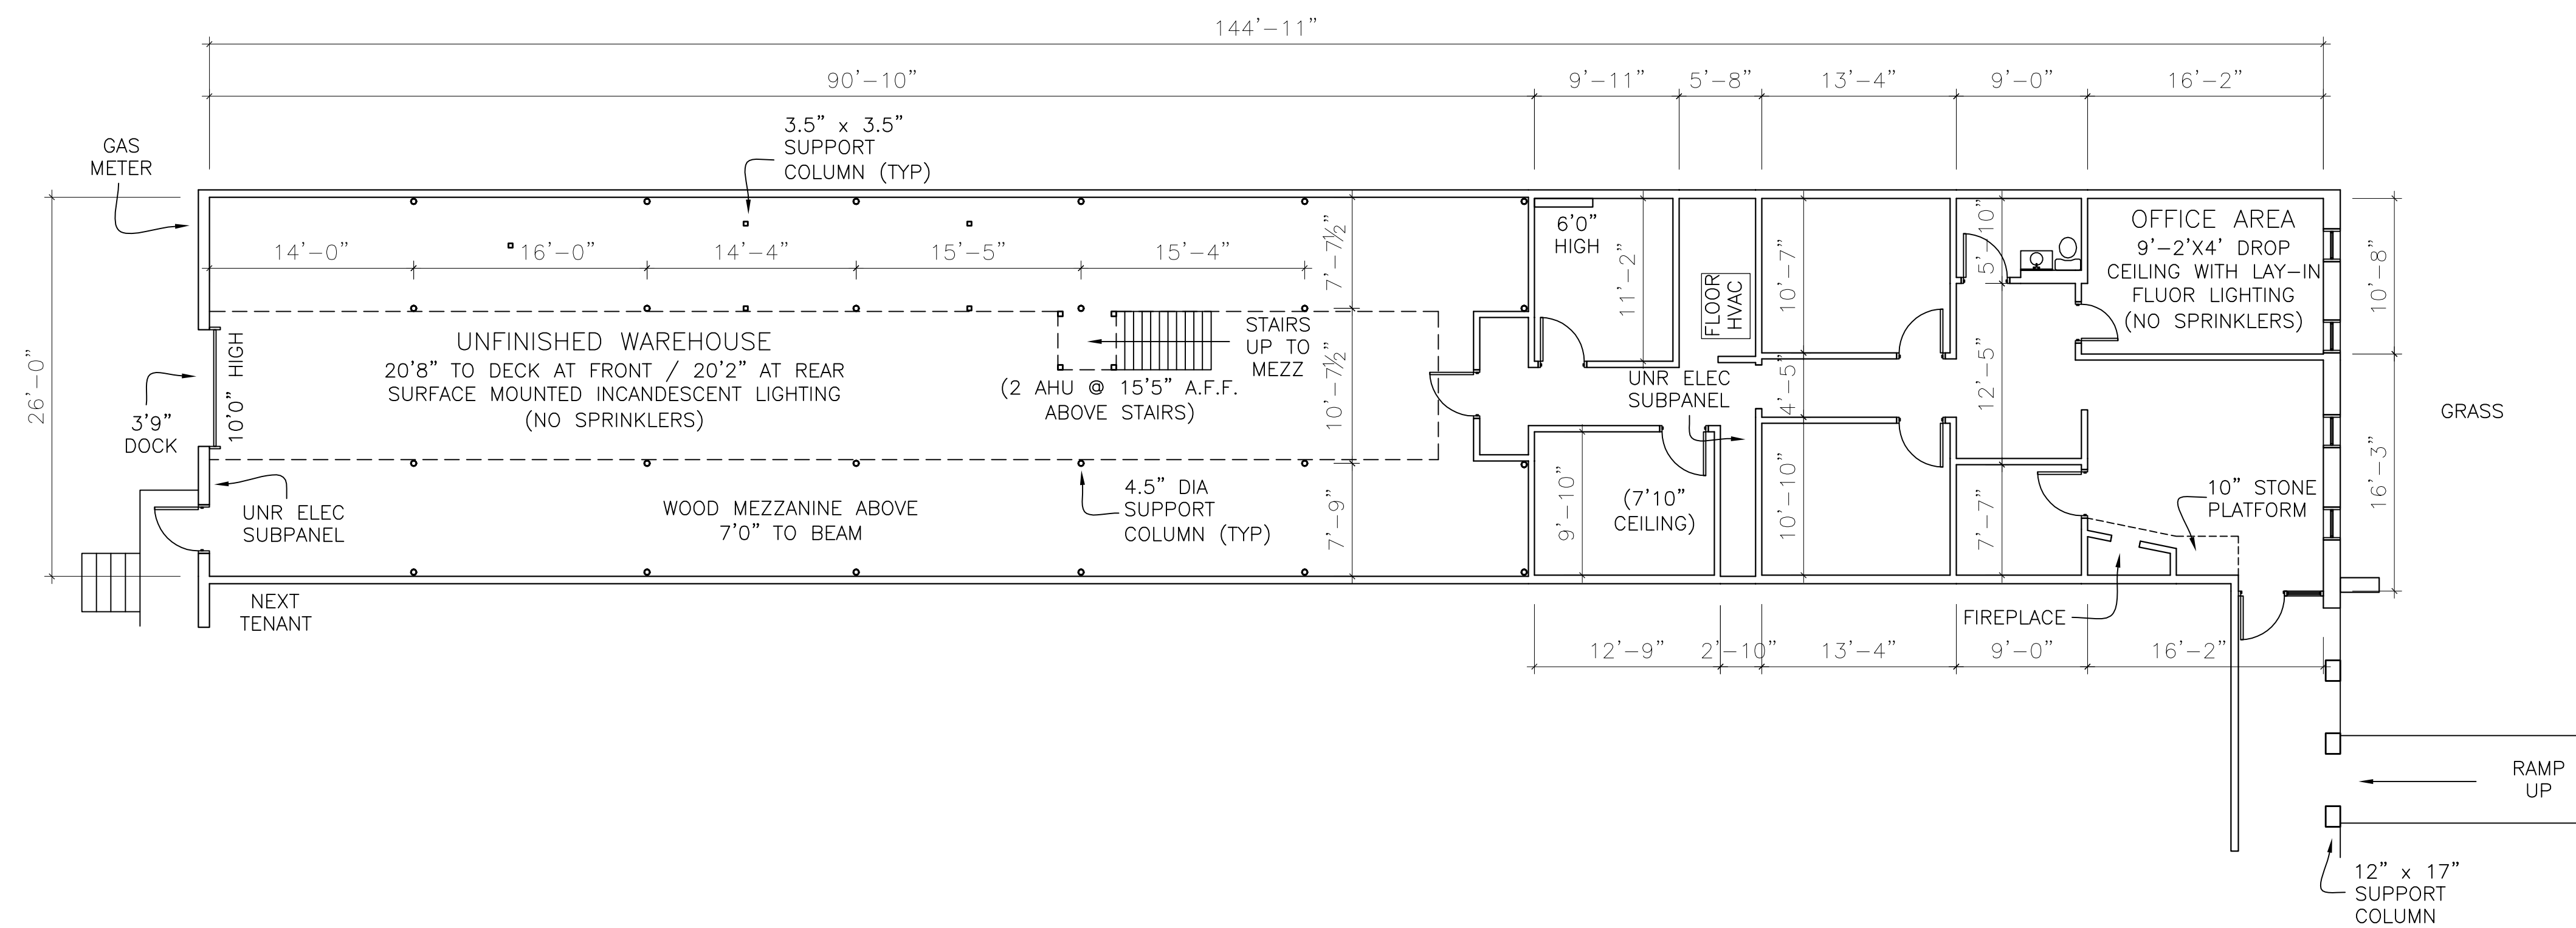

NOTE: DIMENSIONS ARE FOR INTERIOR REFERENCE ONLY,  
 AND DO NOT REFLECT TOTAL SUITE SQUARE FOOTAGE.

EXISTING FLOOR PLAN:  
 SCALE: 1/8" = 1'-0"