

MIMMS ENTERPRISES
 780 OLD ROSWELL
 PLACE SUITE 100
 ROSWELL, GA 30076
 770-518-2200



3535 PEACHTREE RD
 SUITE 520-165
 ATLANTA, GA 30326

770-367-8179 VOICE
 404-601-6029 DATA

PLAN:

SUITE K
 6899 PEACHTREE
 INDUSTRIAL BLVD
 NORCROSS, GA
 30092

DETAIL:

AS-BUILT
 LAYOUT

DATE DRAWN:

AUGUST 23, 2013

SCALE:

AS SHOWN


JOB NO:

SHEET:

A-1

1 OF

SHEETS 1

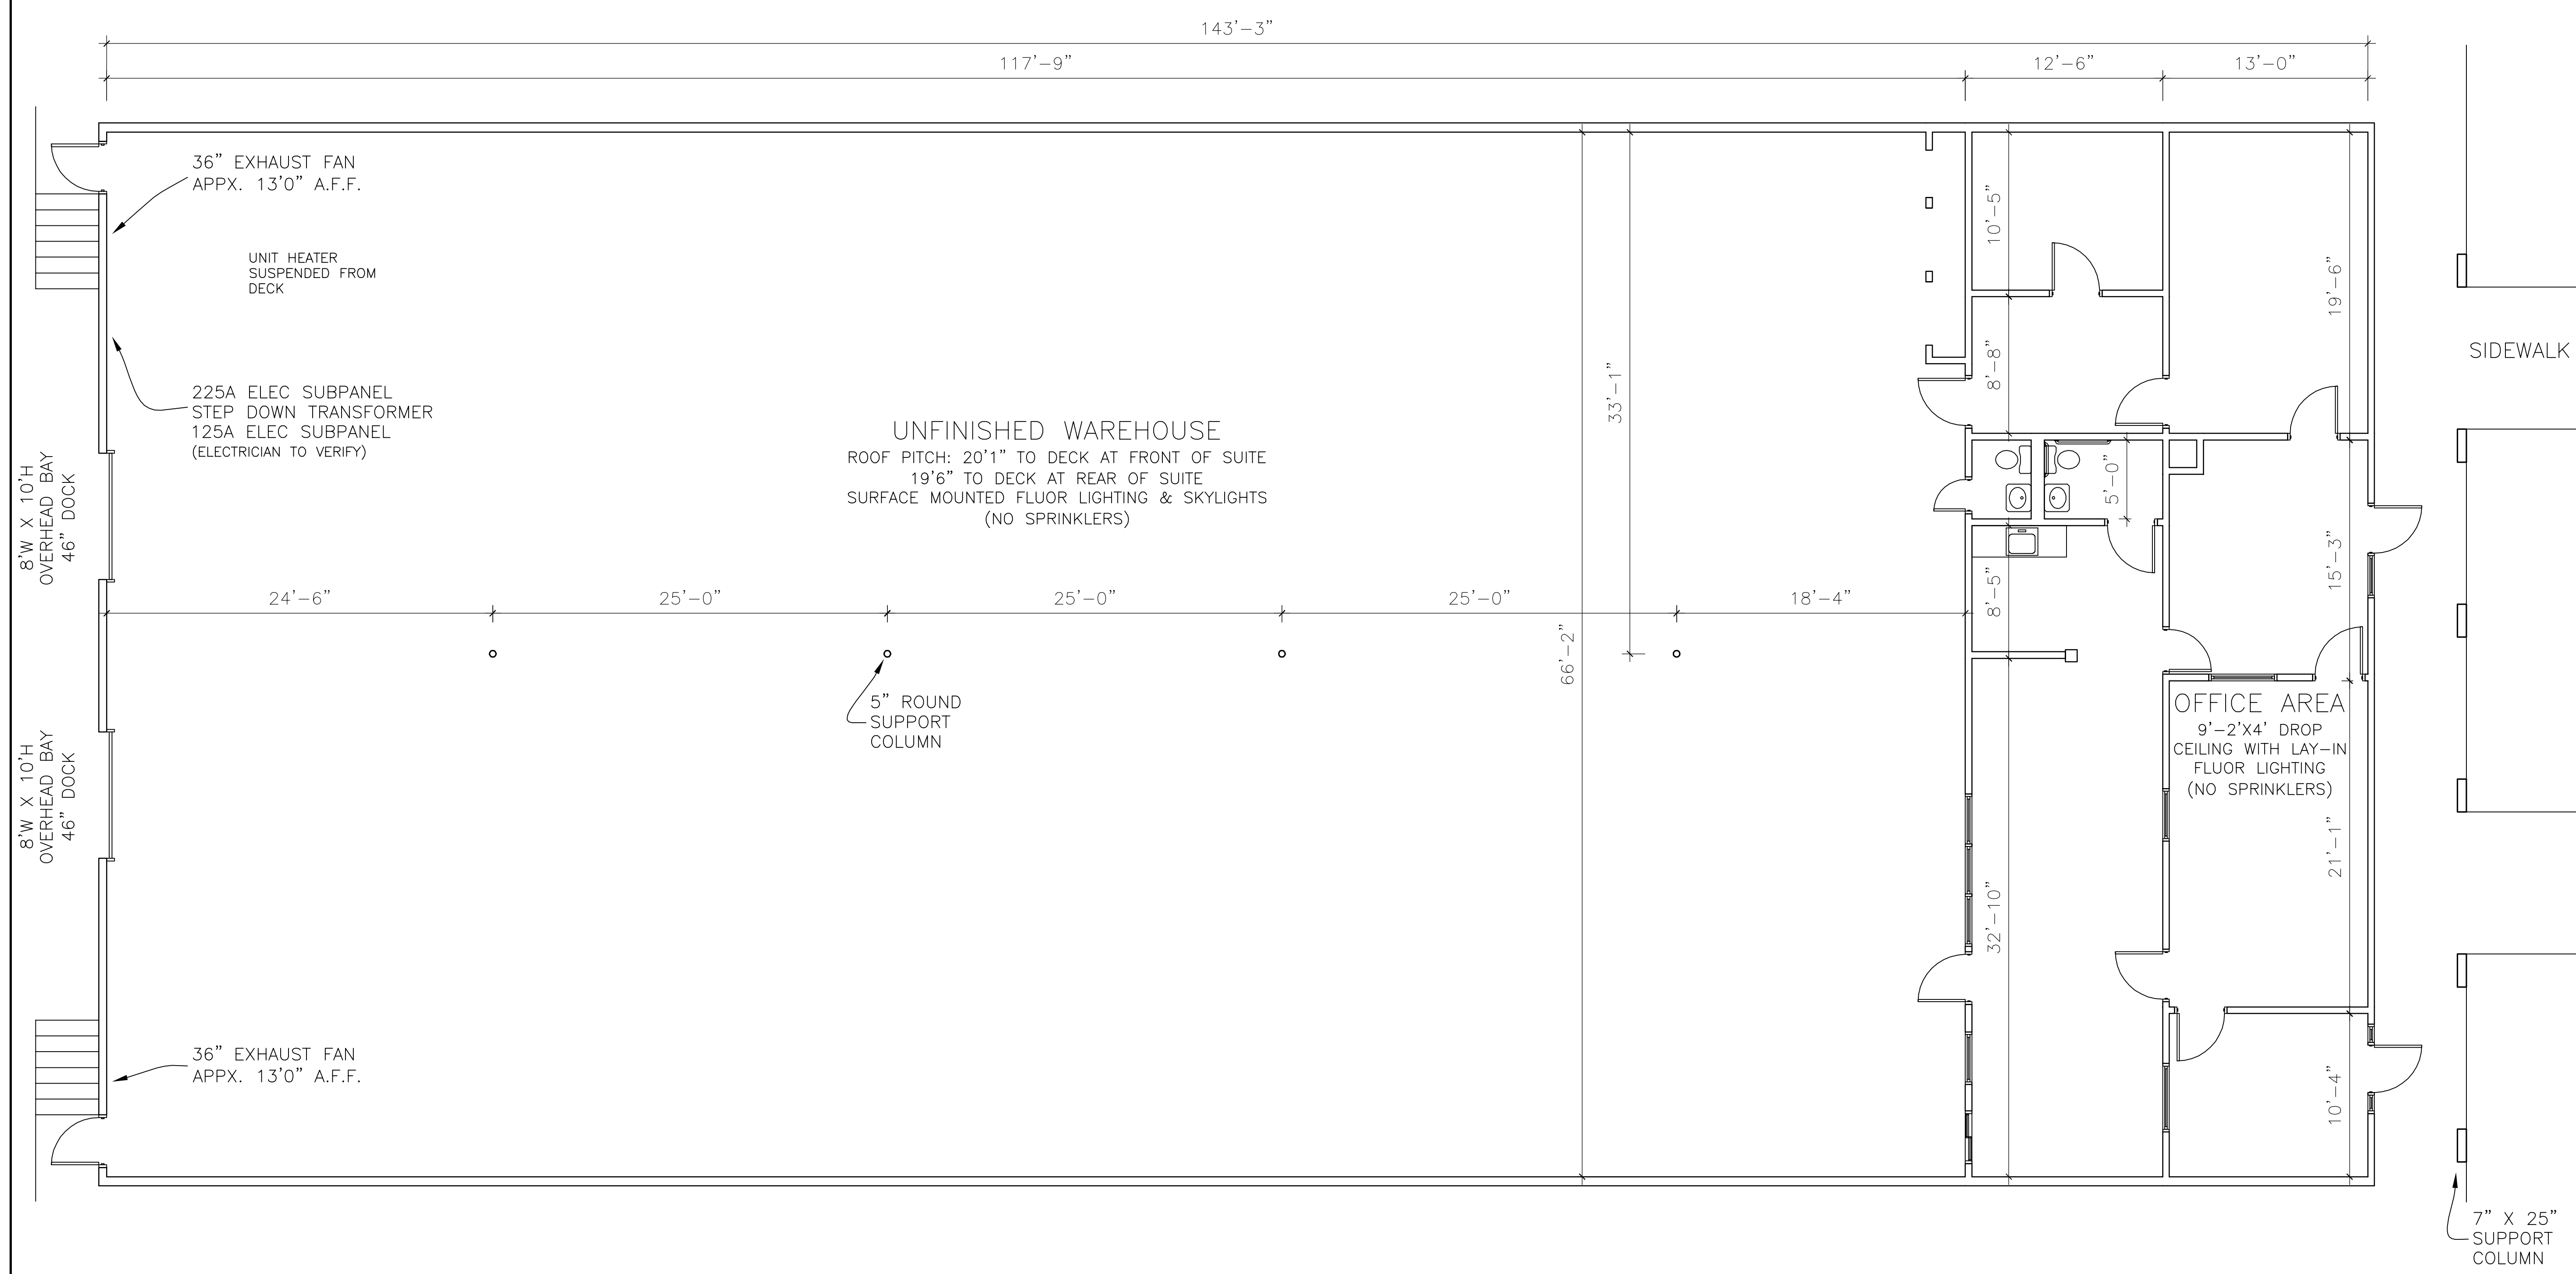

EXISTING FLOOR PLAN:
 SCALE: 3/16" = 1'

NOTE: DIMENSIONS ARE FOR INTERIOR REFERENCE ONLY,
 AND DO NOT REFLECT TOTAL SUITE SQUARE FOOTAGE.